
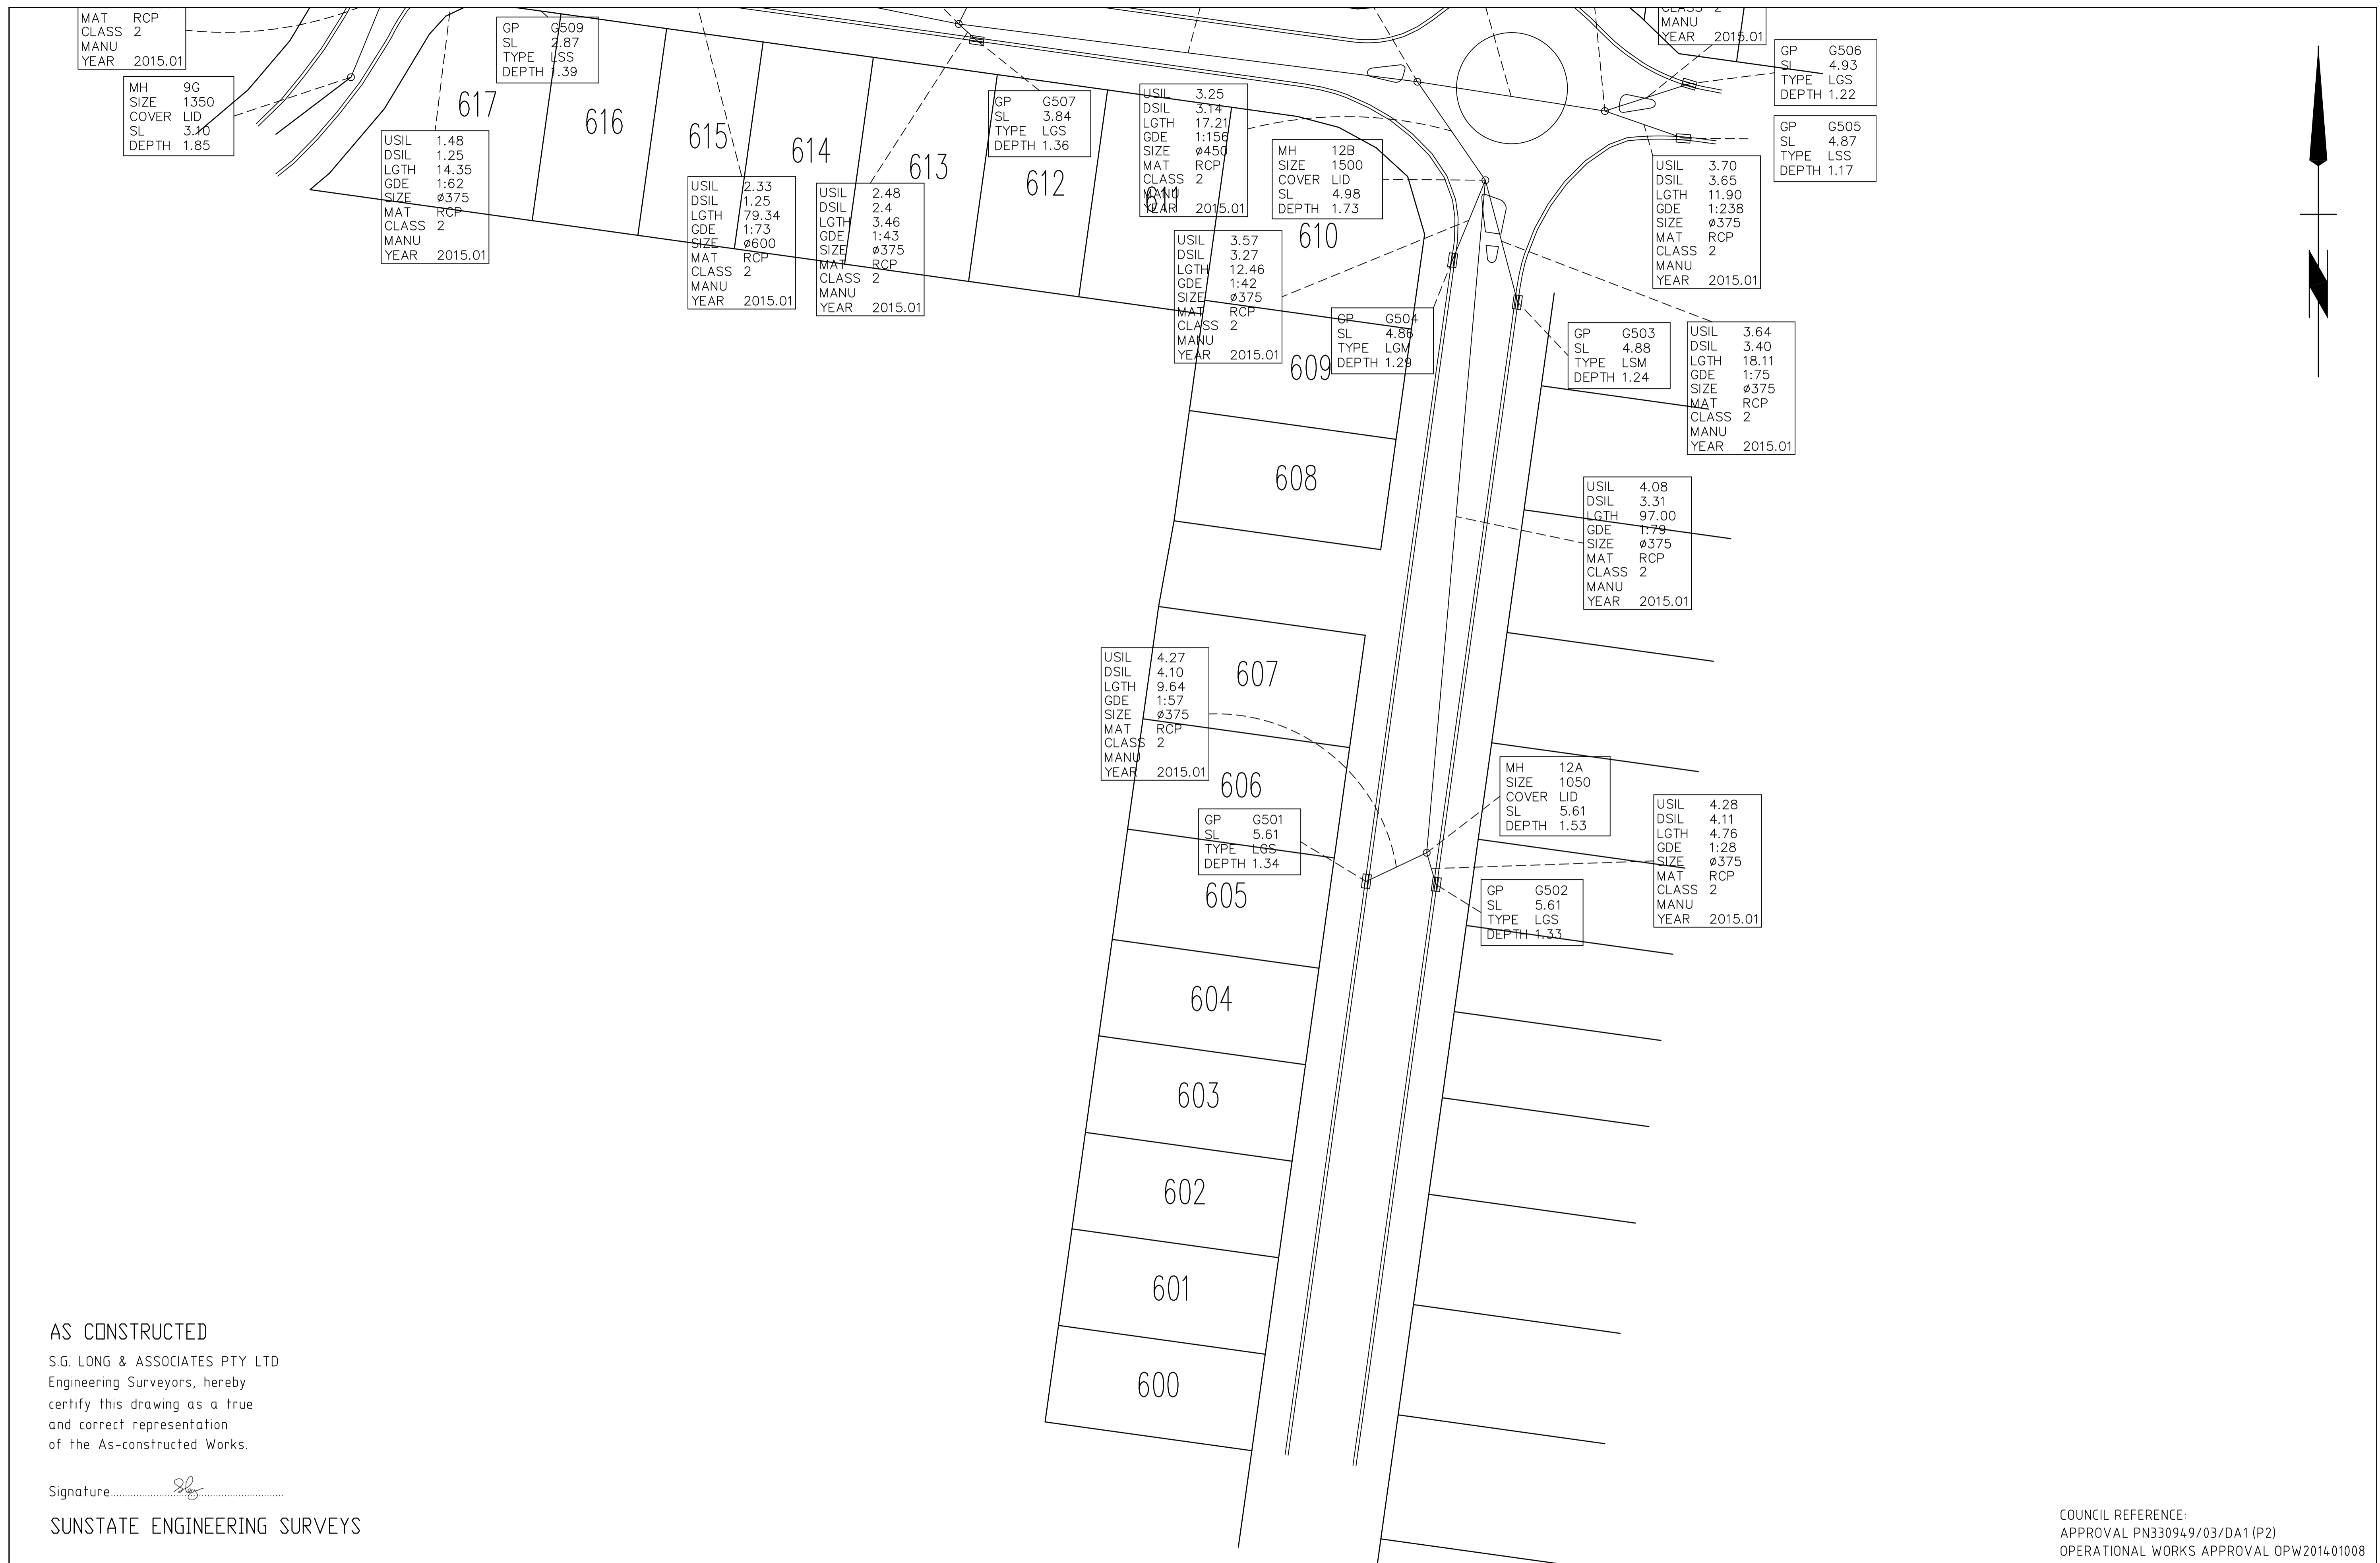


AS CONSTRUCTED
 S.G. LONG & ASSOCIATES PTY LTD
 Engineering Surveyors, hereby
 certify this drawing as a true
 and correct representation
 of the As-constructed Works.

Signature: 
 SUNSTATE ENGINEERING SURVEYS

COUNCIL REFERENCE:
 APPROVAL PN33094/03/DA1 (P2)
 OPERATIONAL WORKS APPROVAL OPW2014.01008

A		05/03/15	PRELIMINARY AS CONSTRUCTED	GH	CADFILE:	SUNSTATE ENGINEERING SURVEYS A.B.N. 33 011 008 521 Unit 2/44 Storie Street, CLONTARF, Q. 4019 Phone: (07) 3283 7611 Fax: (07) 3283 7633 Mobile: 0411 171 322 Email: sunsurv@bigpond.net.au		SURVEYED MD DRAWN GH CHECKED	No. 1 OF 2 SHEETS DATUM: A.H.D.	BMD URBAN 25 Cambridge Parade MANLY, QLD Ph: (07) 3893 7000 Fax: (07) 3893 4088	GAINSBOROUGH GREENS - PRECINCT 6.5 STORMWATER AS CONSTRUCTED STORMWATER DRAINAGE AS CONSTRUCTED	DRAWING No. 14061-6.5-SW01 SCALE: 1 : 500	REV. A
---	--	----------	----------------------------	----	----------	---	--	------------------------------------	------------------------------------	--	---	---	-----------



AS CONSTRUCTED

S.G. LONG & ASSOCIATES PTY LTD
 Engineering Surveyors, hereby
 certify this drawing as a true
 and correct representation
 of the As-constructed Works.

Signature: *[Handwritten Signature]*

SUNSTATE ENGINEERING SURVEYS

COUNCIL REFERENCE:
 APPROVAL PN330949/03/DA1 (P2)
 OPERATIONAL WORKS APPROVAL OPW2014.01008

SUNSTATE ENGINEERING SURVEYS A.B.N. 33 011 008 521 Unit 2/44 Storie Street, CLONTARF, Q. 4019 Phone: (07) 3283 7611 Fax: (07) 3283 7633 Mobile: 0411 171 322 Email: sunsurv@bigpond.net.au		SURVEYED MD DRAWN GH CHECKED	No. 2 OF 2 SHEETS DATUM: A.H.D.	BMD URBAN 25 Cambridge Parade MANLY, QLD Ph: (07) 3893 7000 Fax: (07) 3893 4088	GAINSBOROUGH GREENS - PRECINCT 6.5 STORMWATER AS CONSTRUCTED STORMWATER DRAINAGE AS CONSTRUCTED	DRAWING No. 14061-6.5-SW01 SCALE: 1 : 500	REV. A
A	05/03/15	PRELIMINARY AS CONSTRUCTED	GH	CADFILE:			